


IOWA GEOLOGICAL SURVEY
In Cooperation with U. S. Geological Survey

W-0110

RECORD OF WELL

Location:

Town: Sutherland (N E)
(S W); County O'Brien
NW/4NE-SW sec. 7 T. 94 N., R. 39 W. Waterman Twp.

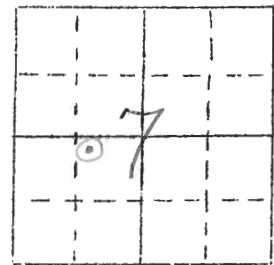

20' from well #1

Well name and number Sutherland Town Well #2

Owner _____ Address _____

Tenant _____ Address _____

Contractor Rasmussen Bros. Address Sioux City

Drillers _____

Drilling dates completed June 1930 to 445' deepened 4/20/38 to 5/11/38

Well data:

Elevations: Drilling curb 1444 feet; Land surface _____ feet

Determined by _____

Topographic position Upland slope

Total depth: Reported 593 feet, Measured _____ feet

filled back with heavy gravel from 615' to 593'

Drilling method cable tool

Hole and casing data 420'3" of 10" casing from surface to 420'3"

(Give amount, size, kind, and depth of all casing; type and

before deepened { 41' of 8" casing from 404' to 445'; bottom perforated with 5/8" diam.
position of seals and packers; cementing; how finished--perforated pipe, screen,
hole with 4" centers, 420-445'
gravel pack, open hole, etc.)

8" casing from 1'9" below top of 10" & extending to 537'6"

65' of 6" perforated casing (5/8" perf on 4" center) lapped 5'
into 8" casing & sealed with lead seal

Original depth to water 242.0 ft. ^{above} curb Date May 11, 1938

Original elevation of water level 1202 ft.; Source of data pumping test

Sources of water: Principal Dakota ss. 531-593; Others _____

IOWA GEOLOGICAL SURVEY
Well Log Record

No. _____

County: O'Brien

Name of Well: City Well No. 2 Town: Sutherland

Location: NW 1/4, NE 1/4, SW 1/4 Sec. 7 T. 94 N., R. 39 W. Waterman Twp.

Curb Elevation: ~~146~~ ^{See G.O.C. Elev} Ft. Present Depth Ft. Final Depth 445 Ft.
Static Level: (Depth to Water ^(Above) Curb) 190* Ft. Pumping Level Ft. *before deepened*

Contractor: Rasmussen Bros., Sioux City Date Drilled: 1930

Description*	F E E T			Description*	F E E T		
	Thick	From	To		Thick	From	To
Yellow clay		0	32	Note: 4' of gravel			
Blue clay		32	175	at bottom of well			
Fine sand		175	185	reported by Council			
Coarse sand & gravel		185	194	March 18, 1938, 449.74			
Fine sand		194	197				
Coarse grav. mxd. with clay		197	200				
Fine sd.		200	204				
Blue clay		204	220				
Brown sticky clay		220	235				
Brown clay mixed with sd.		235	304				
White clay		304	326				
Fine yellow sand		326	395				
Black sticky clay		395	401				
Yellow sd. like ss.		401	410				
Ylv. sd. will stand up to drill		410	420				
White sandstone		420	430				
		430	440				
		440	445				
Was not through sandstone							
(Above from minutes of Council June 17, 1937							

See Water Analysis

*Abbreviate descriptions; use one line for each formation.

Remarks on water zones and casing: 10" casing from surface to 420' 3" 41' of 8" casing from 404' to 445'; bottom perforated with 5/8" dia. holes with 4" centers, 420'-445'

*Howard Rasmussen reports static level of 245'; 190' measured by Mr. John Drake in 1934 who recorded measurement.

Temperature: Air 77 °F.; Water 52 1/2 °F., at 2:30 (A.M.) August 30 1937 (P.M.)

Record obtained from Minutes of town Council Recorded by H.G. Hershey

Incorporated Town of Sutherland, Iowa

MEMBER OF LEAGUE OF IOWA MUNICIPALITIES

Office of the Clerk

Sutherland, Iowa May, 1, 1935 .

W-0110
before deepening

Mr. Allen C. Tester.
Iowa City, Iowa.

Dear Sir:- In reply to yours of April 13th 1935 addressed to our Mayor will send you the log of our 445 foot well which is as follows:-

0---32 feet--yellow clay.
32--175- " -blue " .
175 -185 "--fine sand .
185--194 " coarse sand and gravel.
194--197 " fine sand .
197--200 " coarse gravel mixed with clay .
200--204 " fine sand .
204--220 "blue clay .
220--235 " brown sticky clay.
235--304 " brown clay mixed with sand.
304--326 " white clay.
325--395 " fine yellow sand.
395--401 " black sticky clay.
401--410 " yellow sand like sandstone.
410--420 "yellow sand will stand up to drill.
420--430 " white sandstone. " " "
430--440 " " " "
440--445 " " " "

The well was completed in June 1930. The casing is 10", being the Byers drive type and to date seems to be in good shape. However, 24½ feet of 8" perforated casing was put in the bottom of the well which takes the place of a screen. The water rises 200 feet and we seem to have plenty of it.

The water is very high in mineral content and we have just installed an iron removal plant which has improved the quality very much.

Trusting this give you the desired information,

I remain, Very truly yours,


Troy W. Hughes.
City Clerk

Analysis of
two wells of
2, 14,
445

Name of Well Sutherland W-0110 Sheet No. 1

Depth Range 0-100 Scale: 1 inch=10 feet.


Begin @ 220'
T.D. 448'
City Well

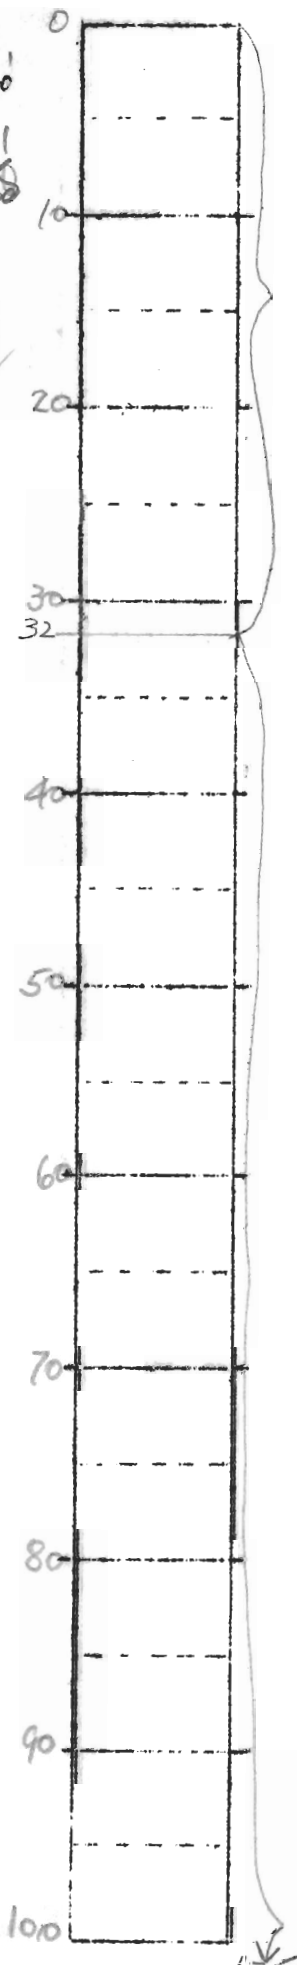

Drift
Shale: 95-100% lt. to dk. yellow, quite hard, dense shale, included in shale 0-50 + st. fine calcite, biotite, chert fine ($\frac{1}{8}$ - $\frac{1}{16}$ mm.) clear, A, qtz sand. Dolo, pyrite and other opaque minerals present with fine fragments of igneous + meta rock.

Name of Well Sutherland W-011a Sheet No. 2

Depth Range 100-200 Scale: 1 inch=10 feet.

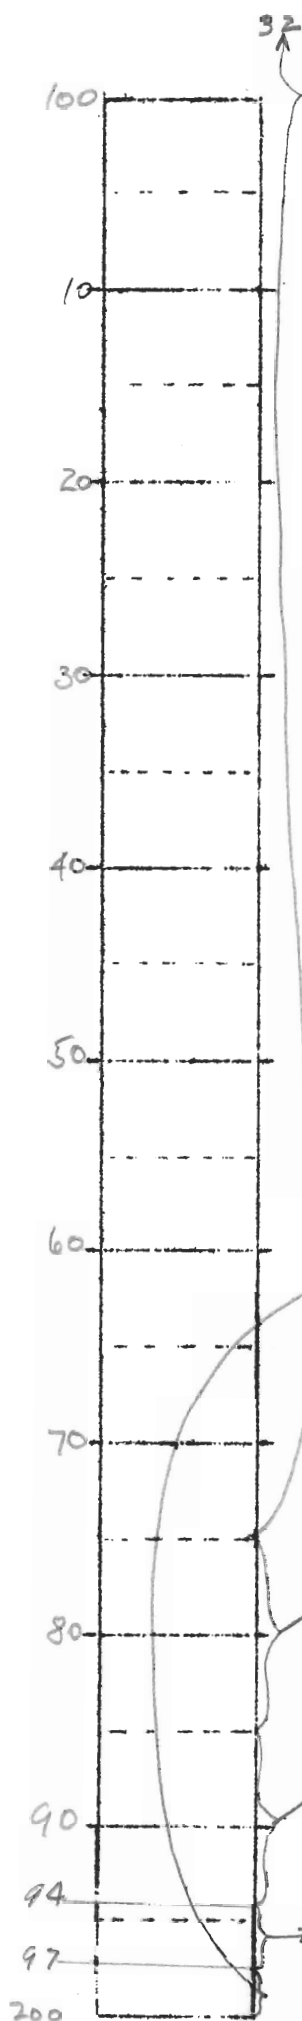

shale: 95-100% dk gray, dense calcareous shale; the calcareous content comes from the included calcite, dolo, + ls. about 1-2% of sample; 2-3% lt gray, A. clear, large, 1- $\frac{1}{2}$ mm. qtz grains, chert, iron oxide and other opaques present, with igneous + meta vox.


Drift

→ sand + gravel: similar to sample at 194 feet.
Drift.


→ sand + gravel: 60-70% lt gray, A to r, unsorted qtz sand. size varies from $\frac{1}{8}$ to 1 mm; 30-40% gravel varying in size up to 4 mm. dolo, ls, chert, fragments of igneous + meta. vox.

→ sand, gravel, cobble: similar to sample at 175 feet but with large cobbles of igneous + meta vox.


→ sand + gravel: 70-80% lt gray, A to C, clear unsorted qtz sand; minor grade $\frac{1}{2}$ - di; 20-30% fragments up to gravel size fragments of sed, igneous, meta. vox + minerals.

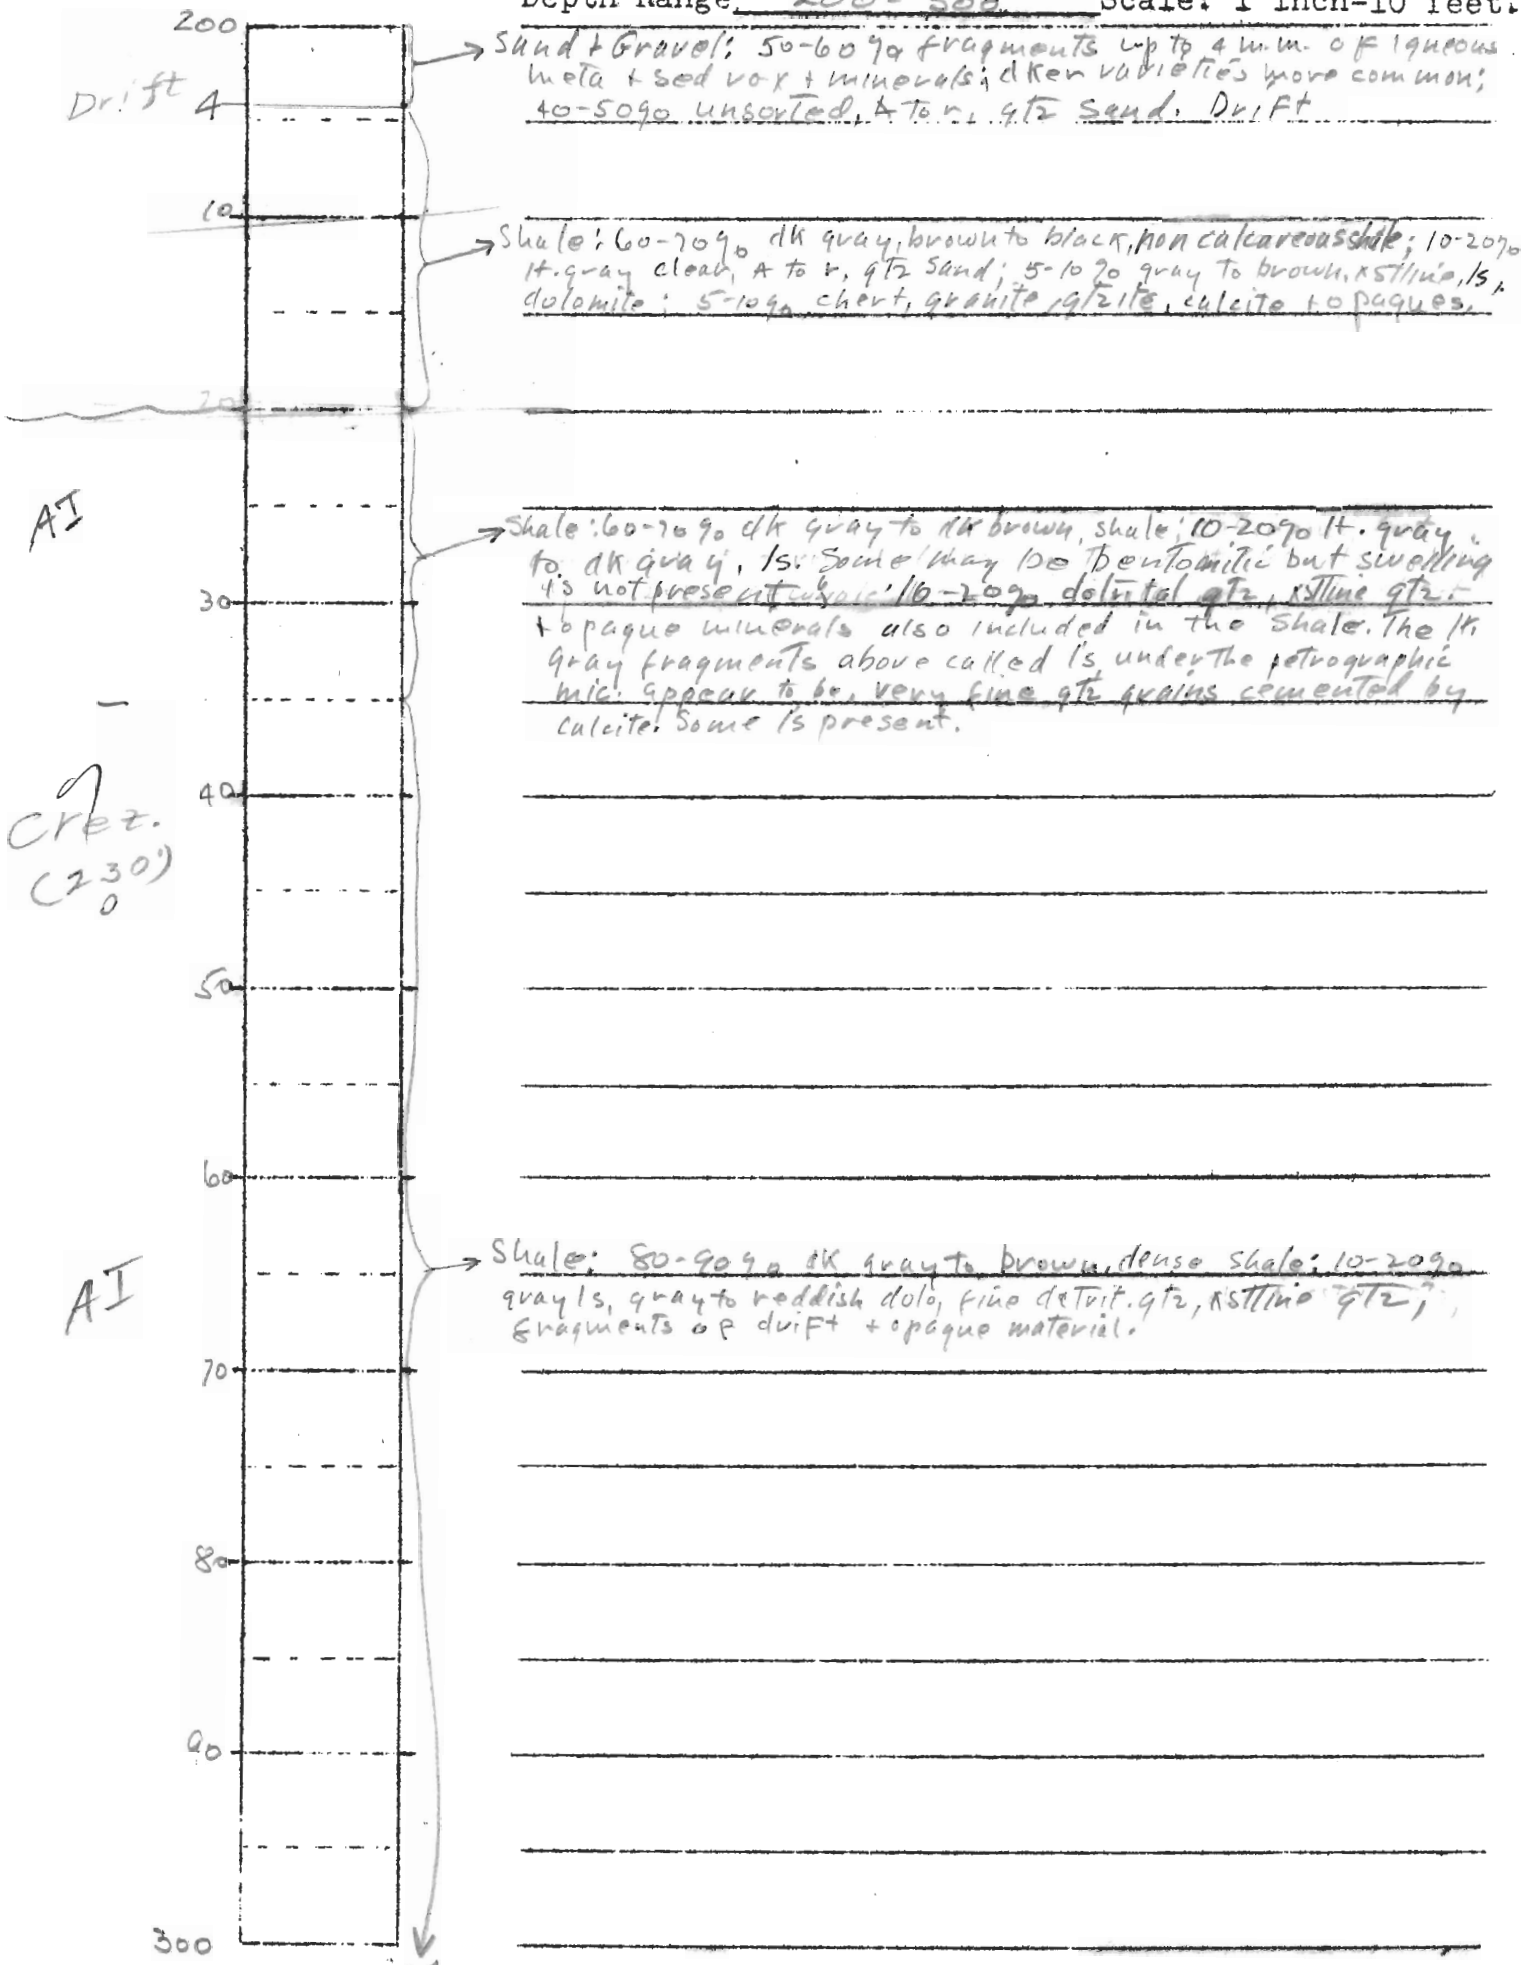

Name of Well Sutherland W-0110 Sheet No. 4
 Depth Range 300-400' Scale: 1 inch=10 feet.

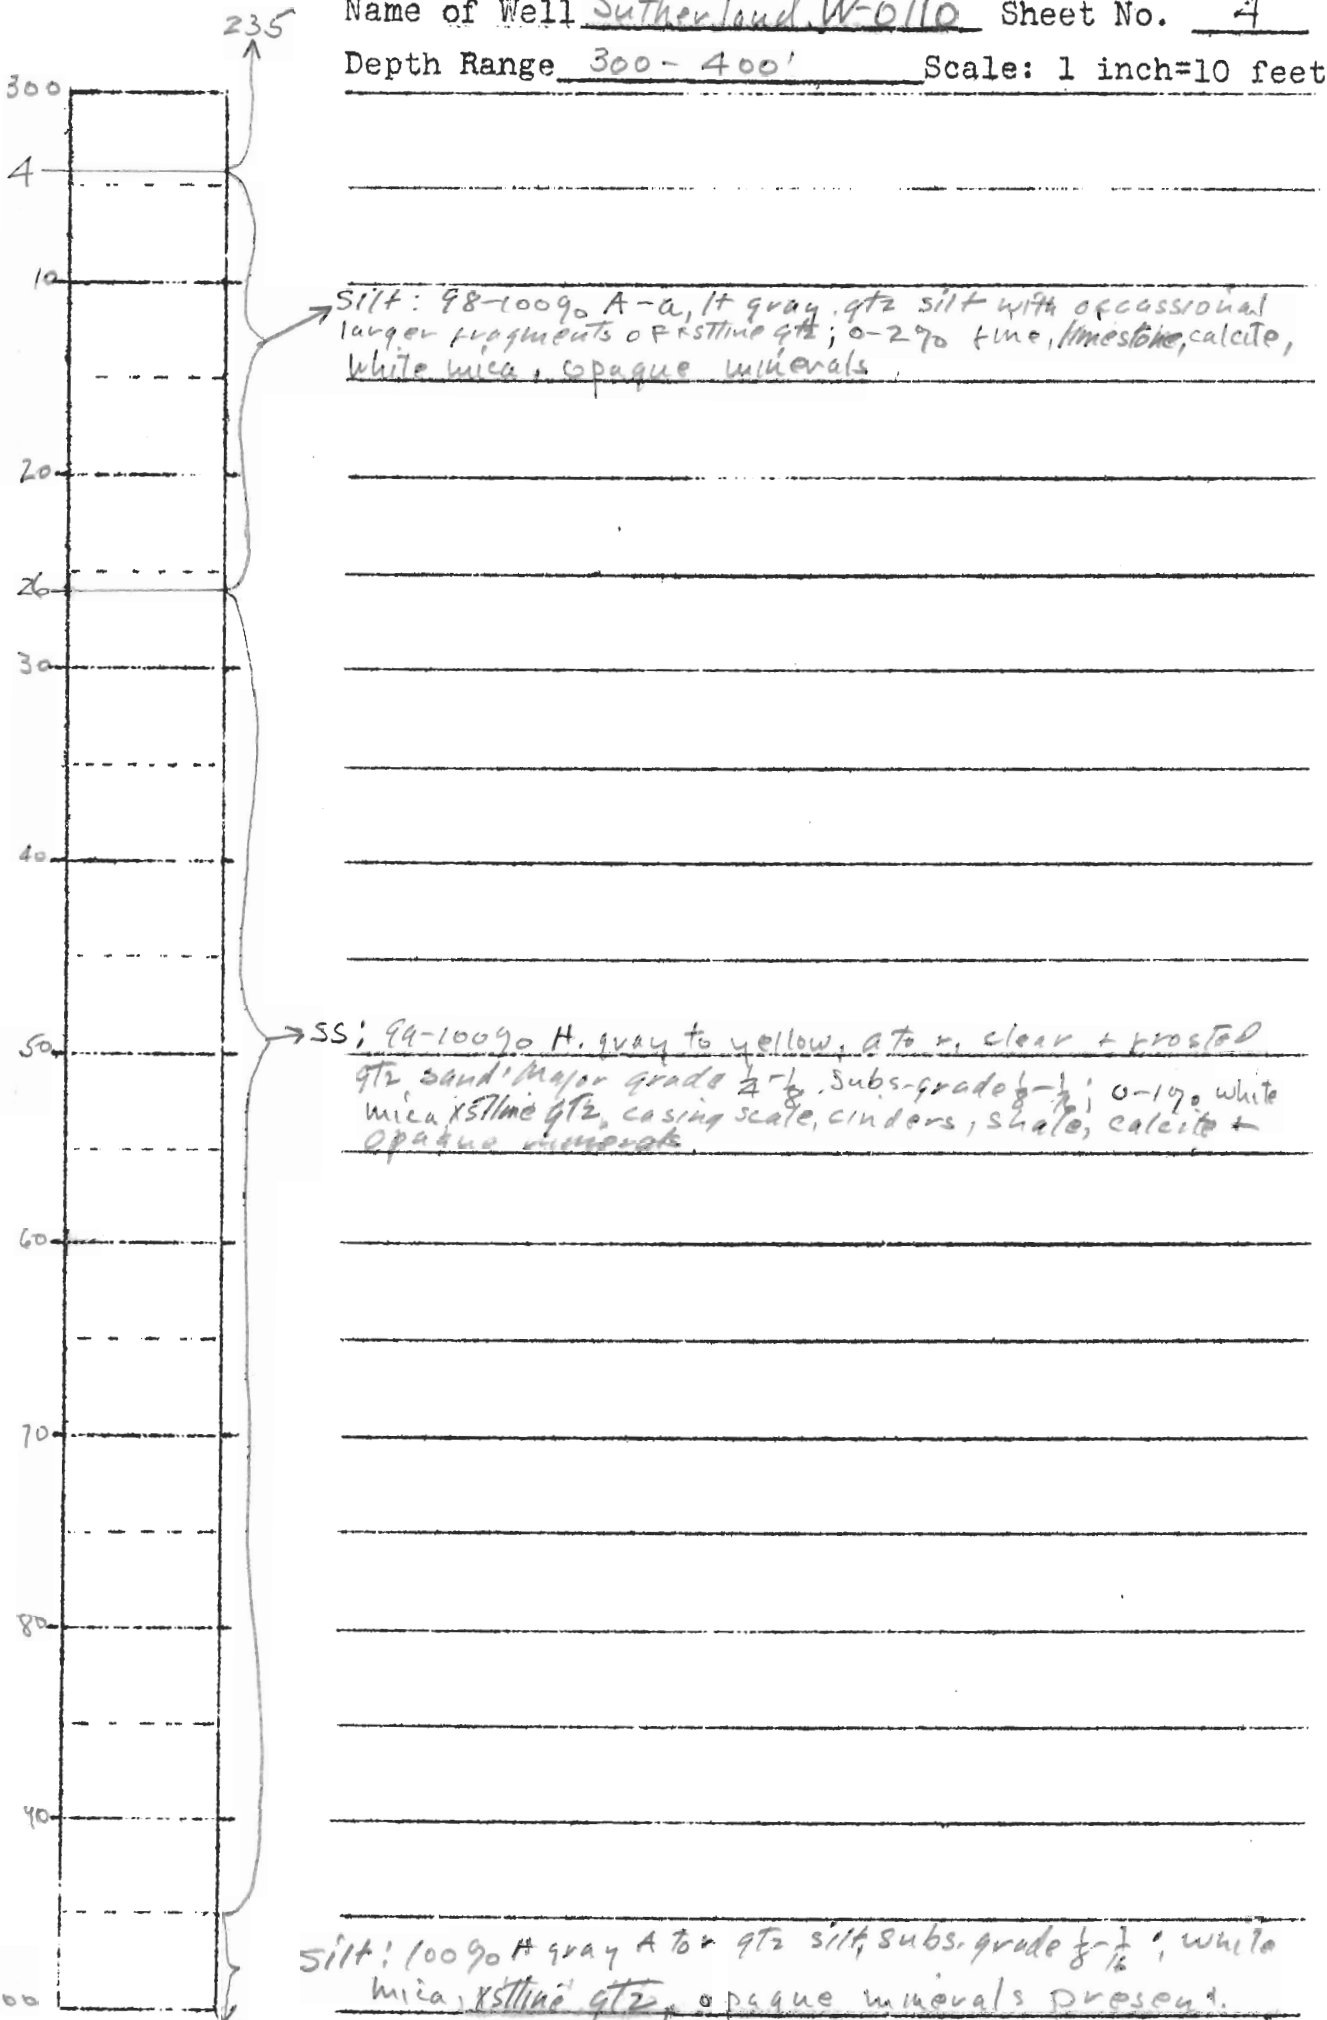

Name of Well Sutherland W-0110 Sheet No. 5
 Depth Range 400-500 Scale: 1 inch=10 feet.

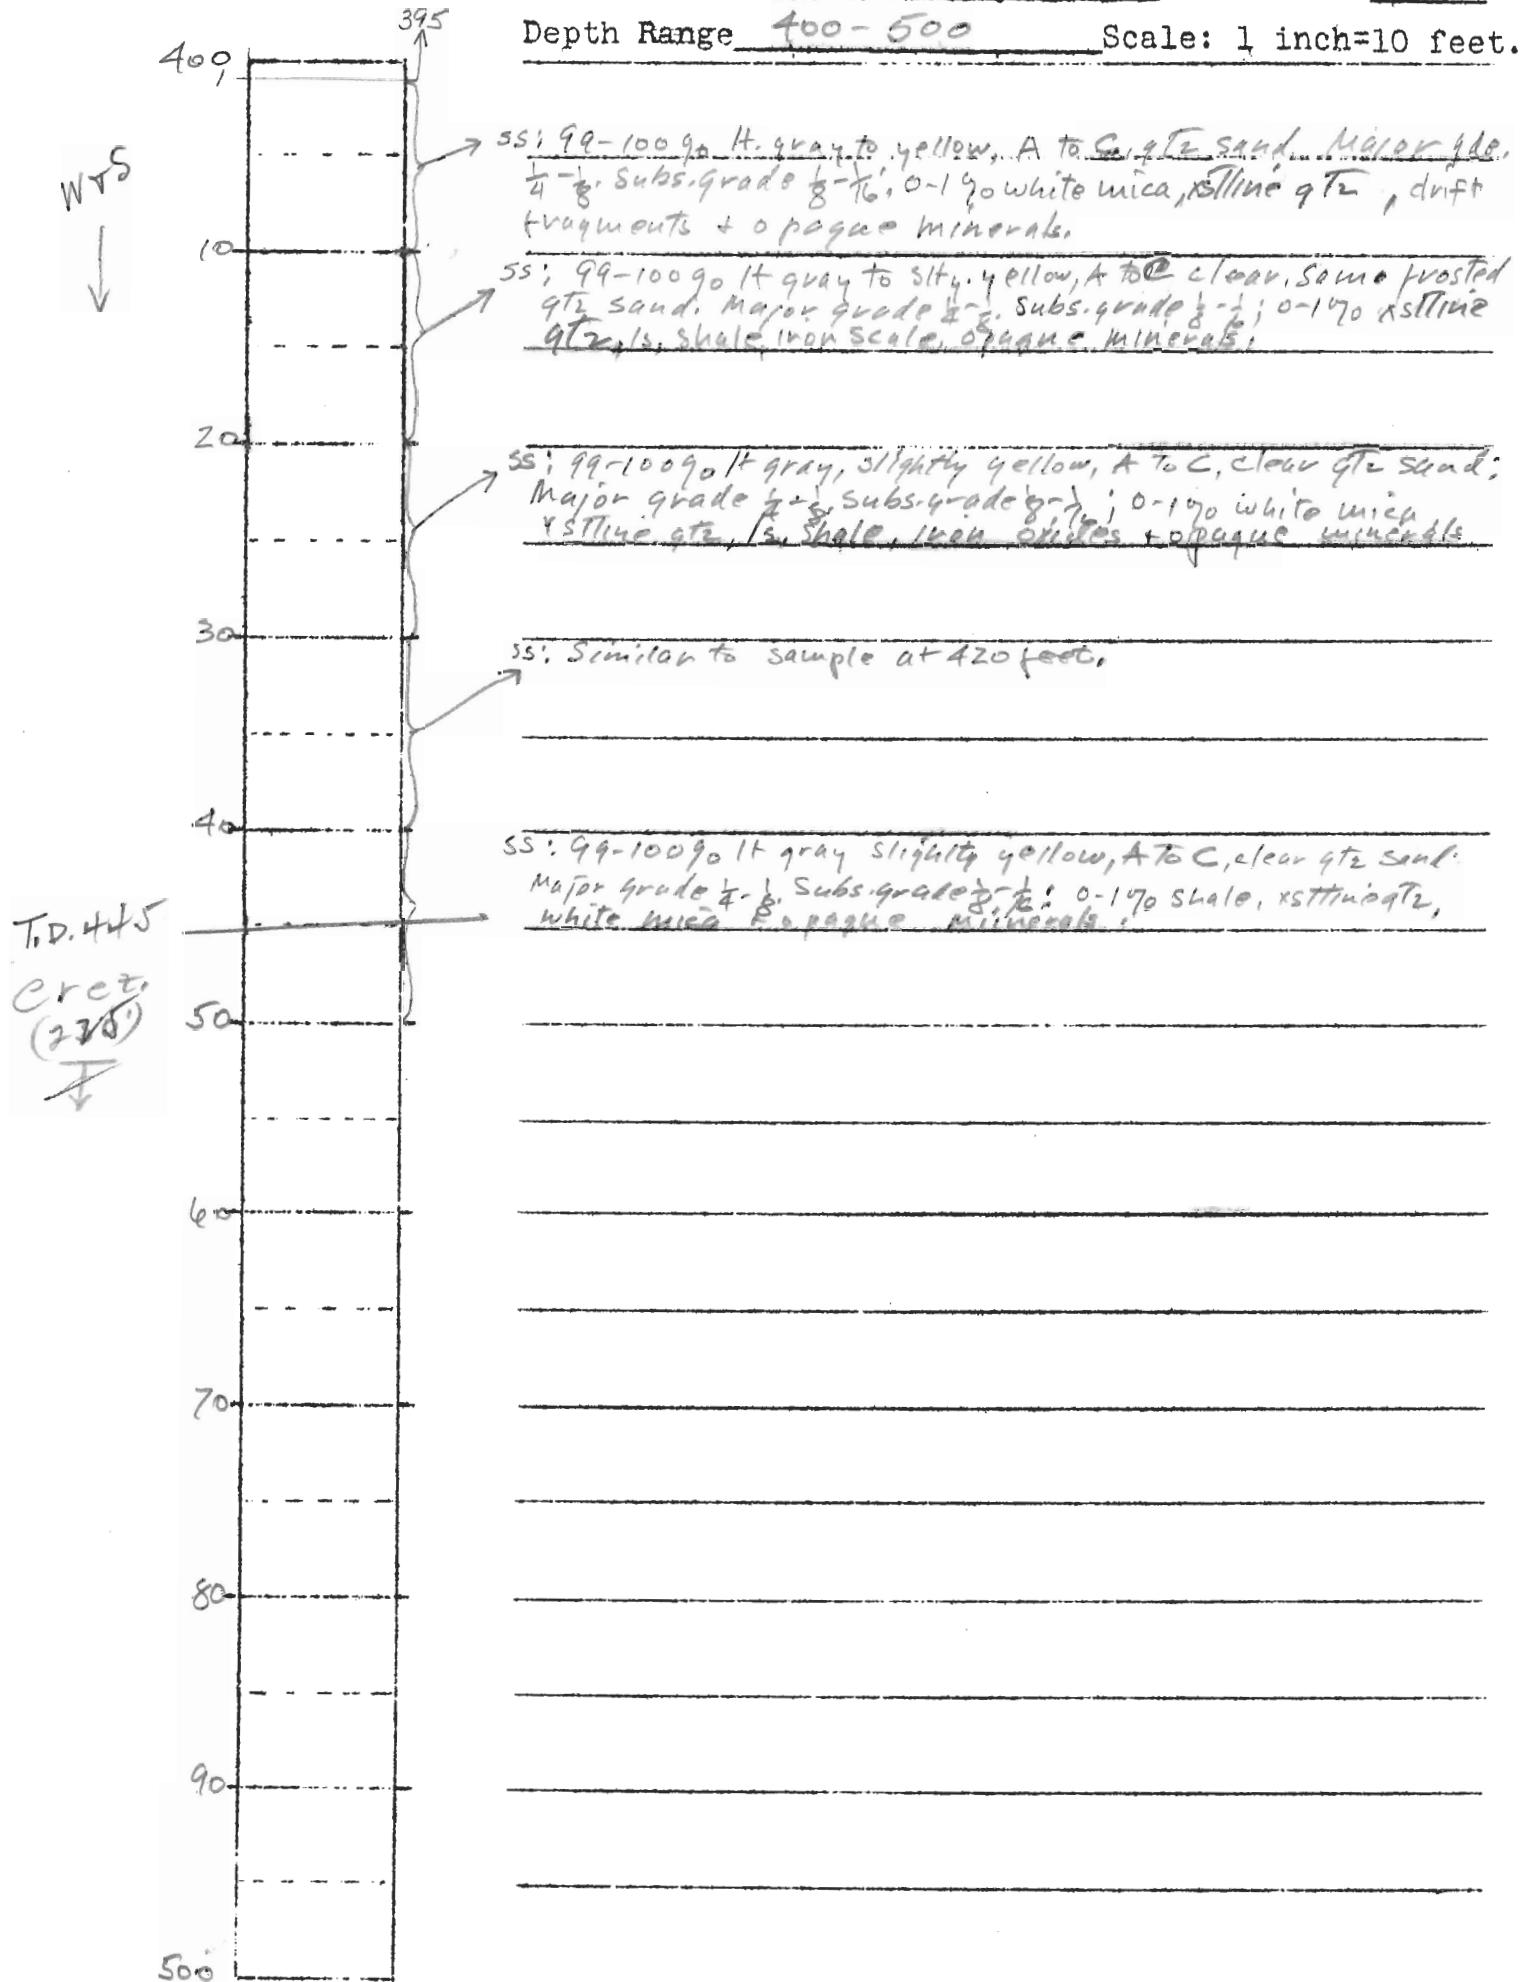

Deep Wells Vic. of Sutherland

O'Brien Co

CE 1552

Section C. M. & St. P. RR Well at Sanborn

	Thick	Depth	
Clay yellow	75'	75'	
Clay blue	125	200	
shale Blue	160	360	
Shale Blue & Green with strata of ls	200	560	
SS, soft, wh, with some sh	155	715	Creta
Sh, gray, streaks of rock	50	765	?
SS, white	45	810	
sh, blue & green, mixed with SS	200	1010	
sh, green & white	246	1256	

Water from 494, 503, 633, & 857', capac. 100 gpm

Head 350' below curt.

No sples. - Log from memory of driller

Clay Co - No data

Buena Vista Co

11 Water anal. composite sheet shows at 1465' Well at Alta drawing from Dakota, St Pet, calc. Hard. 595 - No other information in file no data sheet or Water Anal. sheet.

Cherokee Co

1. State Ho-spital Well 1070' - see Folder
2. Marcus - St. Pet & Jordan 1300' from W. Anal. Folder

	<u>Curb Elev.</u>	<u>Total Depth</u>	<u>Depth To ss (st. pet?)</u>	<u>Sea Lev. Elev. st. pet.</u>
Sanborn RR Well O'Brien Co.	1552'	1256	765'	+787'
Alta Buena Vista Co.	1514	1465	(? (1415 4 st. pet. 50' thick)	
Cherokee Cherokee Co	1338	10	1015	+323'
Marcus Well Cherokee Co.		1300'	?	
Sutherland O'Brien				

Telephone conversation with Mayor Reiste of Sutherland & "Red" Carson drilling for Rasmussen Well Co., re deepening 444' well at Sutherland

Log:

See old log

From Mr. Carson

Yellow sandstone		444 - 470
Blue sh with traces of ss.	30	470 - 500
Very coarse yellow ss.	30	500 - 530
White shale	1	530 - 531
White ss		531 - 560 not thru

Casing to 506

Note: At request of Mayor Reiste I visited Sutherland Mar. 19, 1938 and discussed their problem. Water at that time was very hard & town wanted to know what could be done. Believing production at 444' to be from U. Dakota ss I suggested drilling deeper to L. Dakota ss.

Today, suggested that drilling be carried to bottom of white ss beginning at 531. That casing be carried to 531' & that annular space between 10" & 8" casing be grouted with neat cement to above level of upper SWL. i.e. 70'

A.G. H.

400
10
20
30
40
50
60
70
80
90
500

455'
SS, buff, med. gr. (Maj Gr. 1/2-1/4 mm, PS 1/4-1/8 mm), ~~ang~~ to subang, clear to frosted, 95% slightly iron coated on surface, well sorted; 5% lg. frag. blk. Mn oxide; sand) 90% O₂; rare flakes of mica.

450'
SS, buff, sim to ss. splc. 455-450' in color, grain size, sorting, & approx. comp.

455'
SS, buff,

460'
SS, buff,

466'
SS, buff, med. (M.G. 1/2-1/4 mm, PS 1/4-1/8, 2nd Subs 1/4-1/16 & 1-1/2 mm), ang. to subang., clear to frosted; 80% of gr. slightly coated with iron oxide; sorting poor, some silt present.; 10% br. dr-ab, fine x l in a dr, non efferv.

470'
sh, med gray, soft (as well mud), silty & mica ceous, non calc., structureless

475'
sh " " " & frag.


480'
sh

485'
sh

490'
SS, lt. gray, v. fine gr. (M.G. 1/8-1/16 mm, ps. 1/16-1/32 & 1/4-1/8 mm) well sorted, ang, minn silty. 40% 60%

495'
SS, pale buff, v. fine gr. (M.G. 1/8-1/16 mm, PS 1/16-1/32 & 1/4-1/8 mm) well sorted, ang, micae., v. slightly iron stained, 75%; 25% lt. gray sh. (cav); 3 frag. ~~abraded~~ pale buff sh. with 1/2-1 mm shell drt. br. Fe oxide, hard, which peels off.


500'
SS, pale buff, v. fine & med. (M.G. 1/8-1/16 mm, PS 1/16-1/8 mm), ang to subang, clear to frosted, poorly sorted, v. slightly iron stained & 5% cav'd gray sh.

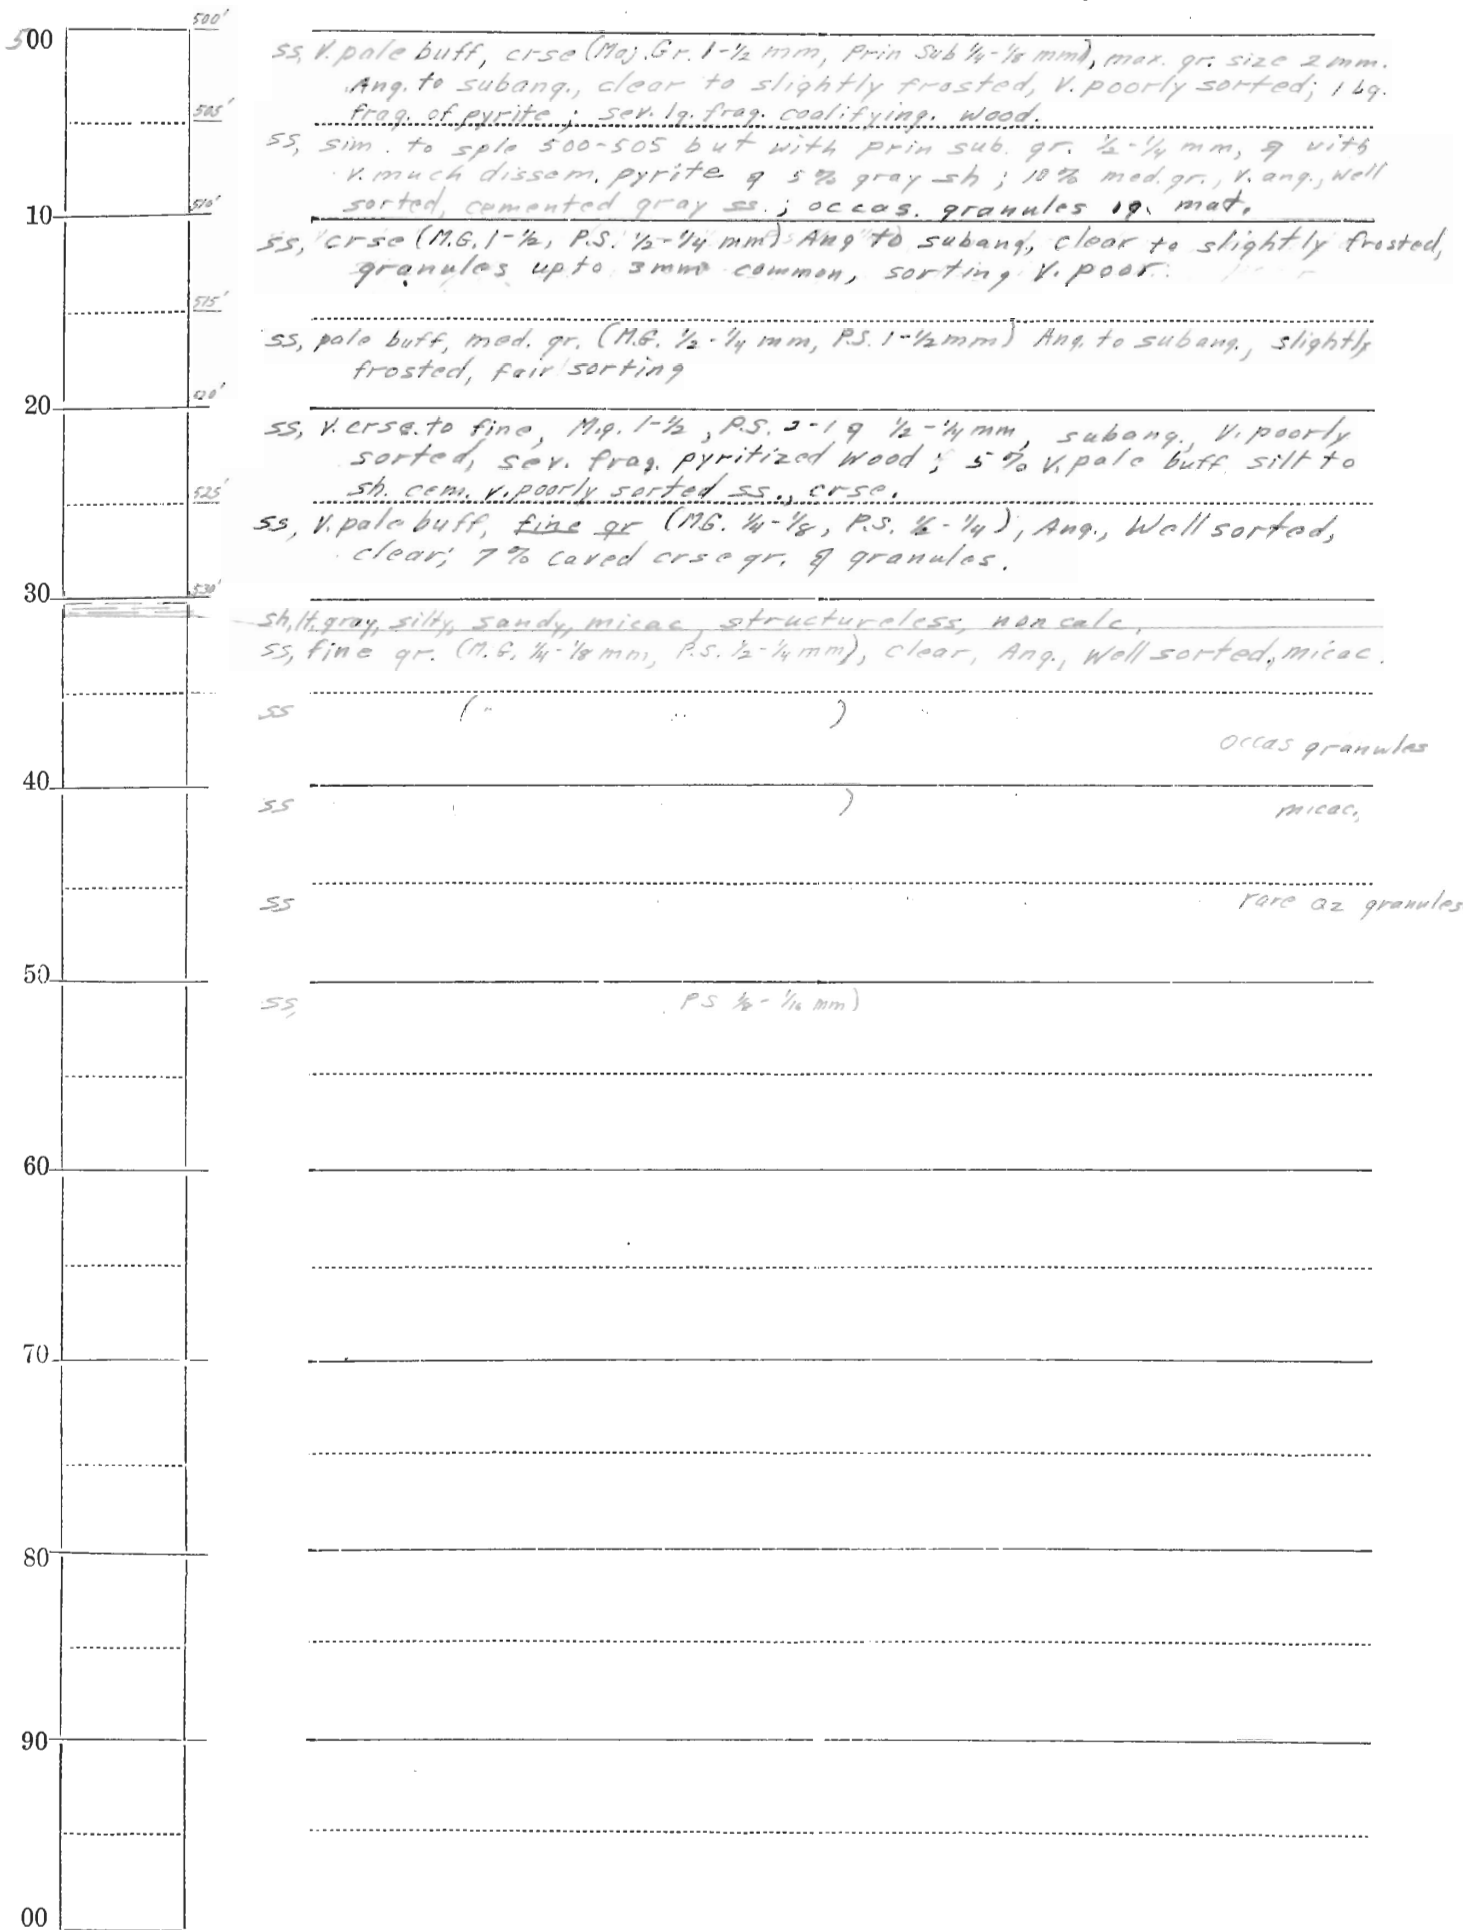

1930

Location NW NE SW, Sec 7, T94N, R39W, Waterman Twp Date Drilled Deepened 1938 Analyst Hershey (May 6, 1938)

Curb elev = ~~445~~ See G.O.C. Elev.

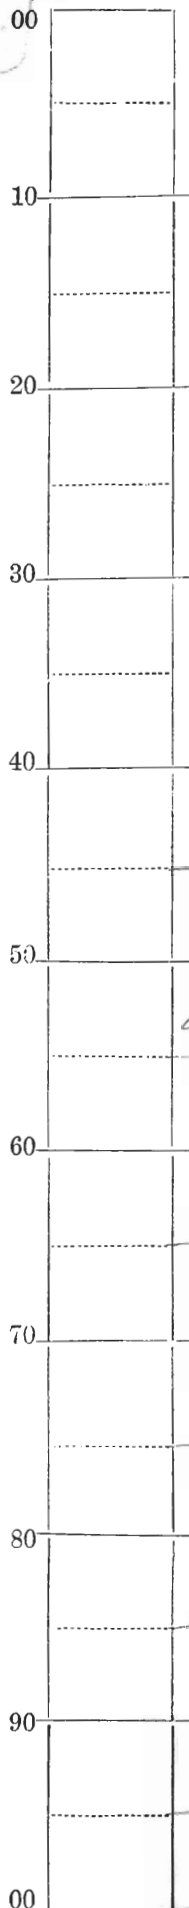

Note: This well, drilled in 1930, was deepened below 445' in April & May 1938.

See sheet No. 5

- 445 Sandstone - light yellow; angular to curvilinear quartz; clear & stained yellow, with some few pink grains; maj. gr. $\frac{1}{2}$ - $\frac{1}{4}$ mm; prin. subs. $\frac{1}{4}$ - $\frac{1}{8}$, 1- $\frac{1}{2}$ mm. 1% white & gray chert with trace of buff ls. & igneous material. Much casing scale.
- 450 Sandstone - light yellow; angular to curvilinear quartz chiefly; clear & stained; maj. gr. $\frac{1}{2}$ - $\frac{1}{4}$ mm; prin. subs. $\frac{1}{4}$ - $\frac{1}{8}$. 1% white & gray chert etc. No
- Out → 455 Sandstone - light gray, angular to curv., clear qtz. 99%; maj. gr. $\frac{1}{8}$ - $\frac{1}{16}$ mm; prin. subs. $\frac{1}{16}$ - $\frac{1}{32}$ mm. same cave. White mica & fresh pyrite & other extr. material
- 455 Sandstone - light yellow, angular to curvilinear clear stained qtz. chiefly; maj. gr. $\frac{1}{2}$ - $\frac{1}{4}$ mm; prin. subs. $\frac{1}{4}$ - $\frac{1}{8}$ mm. 1% white & gray chert, ls. etc. Much casing scale.
- 460 Sandstone - light yellow, angular to curvilinear clear & stained qtz. 99%; maj. gr. $\frac{1}{2}$ - $\frac{1}{4}$ mm; prin. subs. $\frac{1}{4}$ - $\frac{1}{8}$ mm; 1% white & gray chert, ls. etc. Much casing scale. Similar to 445-460
- 465 Sandstone 85-90% - light yellow, angular to curvilinear clear to stained quartz maj. gr. $\frac{1}{2}$ - $\frac{1}{4}$ mm; prin. subs. $\frac{1}{4}$ - $\frac{1}{8}$ mm. Similar to 445-465 Dolomite 10-15% - light brown, very fine grained, carrying rounded qtz grains in part & dark material (?), cherty (?). Much casing scale
- 470 Siltstone - light gray, clayey, sandy, high in white mica, non-calcareous. No structure seen. Some casing scale. No dolomite seen.
- 475 Siltstone & shale - light gray, non-calcareous, micaceous, faint trace of structure in one fragment.
- 480 Shale - light gray, non-calcareous, silty, micaceous.
- 485 Shale - light gray, non-calcareous, silty, micaceous 60%
? 40% Sandstone - light gray, angular to curvilinear qtz. chiefly; maj. gr. $\frac{1}{2}$ - $\frac{1}{16}$ mm; prin. subs. $\frac{1}{16}$ - $\frac{1}{32}$ + $\frac{1}{4}$ - $\frac{1}{8}$ mm. Few larger fragments.
- 490 Sandstone - light gray, angular to curvilinear clear qtz. chiefly, maj. gr. $\frac{1}{2}$ - $\frac{1}{16}$ prin. subs. $\frac{1}{16}$ - $\frac{1}{32}$, $\frac{1}{4}$ - $\frac{1}{8}$ mm; micaceous. Iron shell concretion filled with gray, unctuous, non-calc. bentonite?; several fragments of medium gray, soft plastic, unctuous, material
- 495 Sandstone - light gray, angular to curvilinear clear qtz. chiefly; maj. gr. $\frac{1}{2}$ - $\frac{1}{16}$ prin. subs. $\frac{1}{16}$ - $\frac{1}{32}$, $\frac{1}{4}$ - $\frac{1}{8}$ mm; micaceous. 50% Sandstone - light yellow, ang. to curv., maj. gr. $\frac{1}{2}$ - $\frac{1}{4}$ chiefly qtz.
- 500 Shale - gray, micaceous, silty

Location Date Drilled Analyst Hershey (May 6, 1938)

